



North

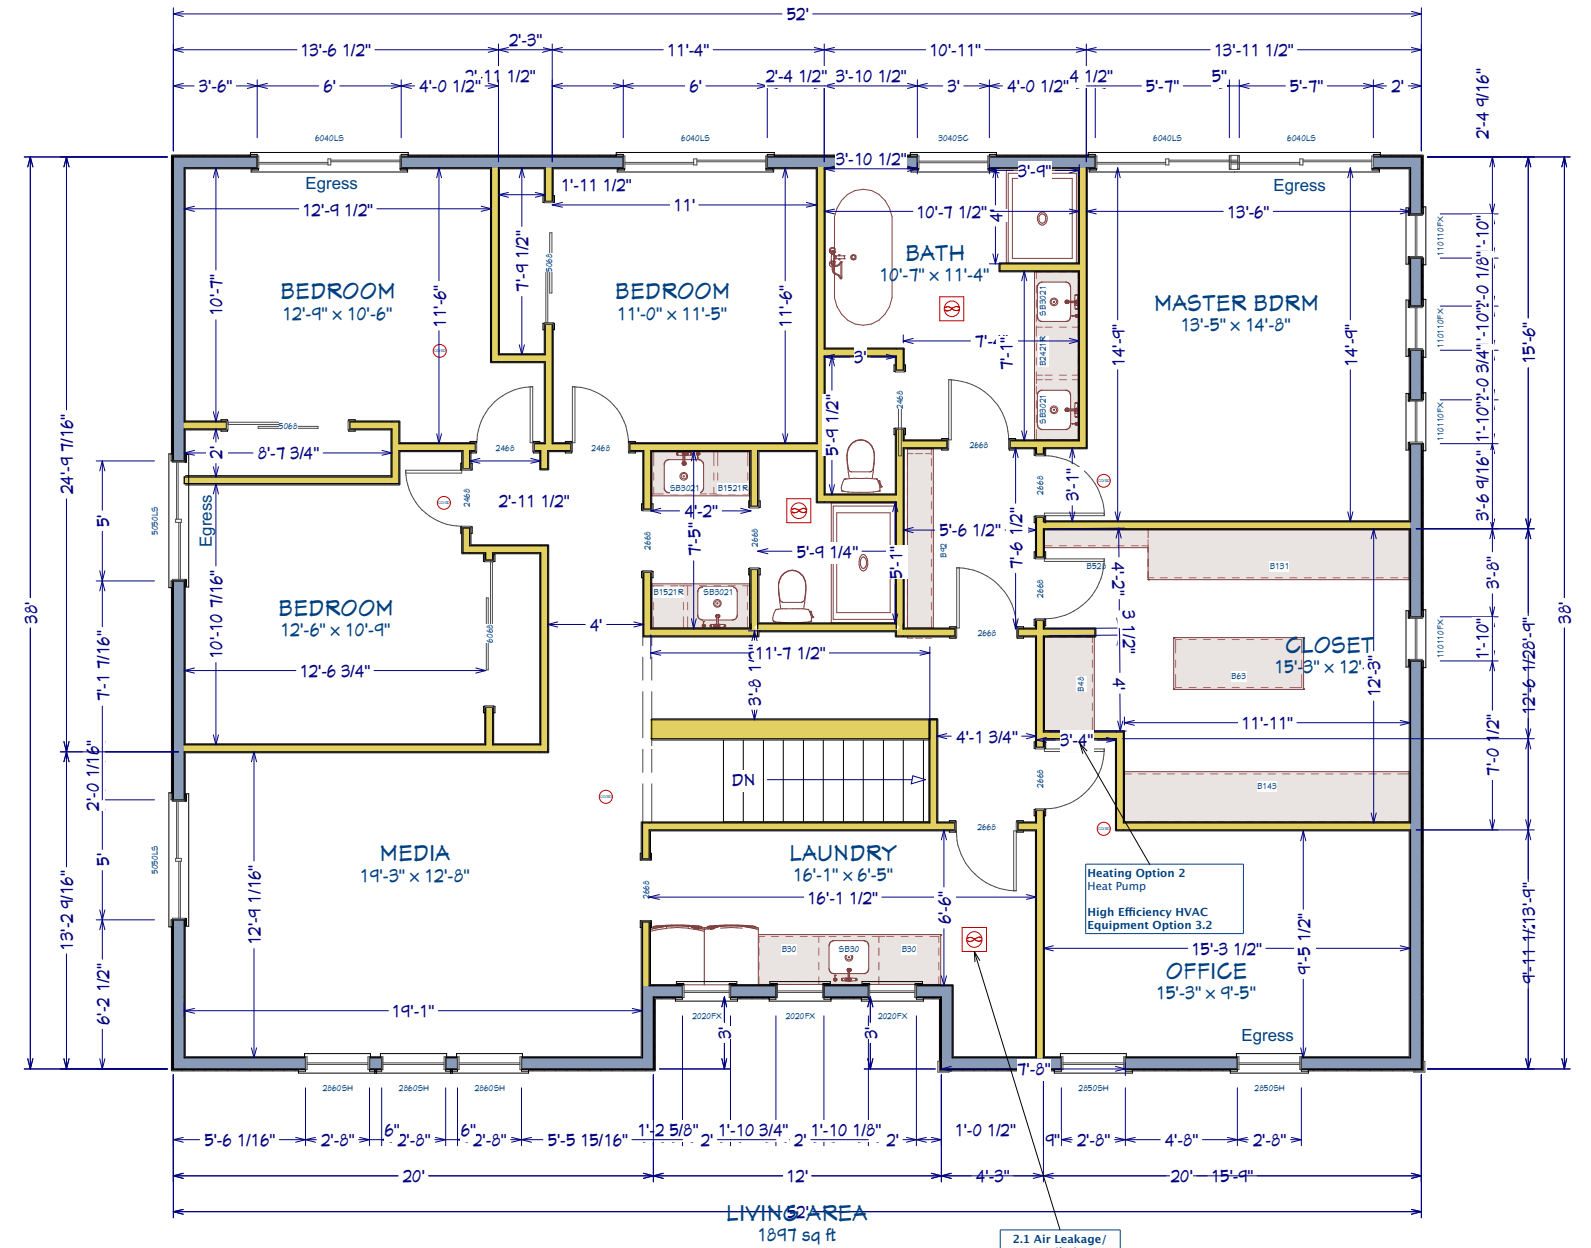

1st Floor

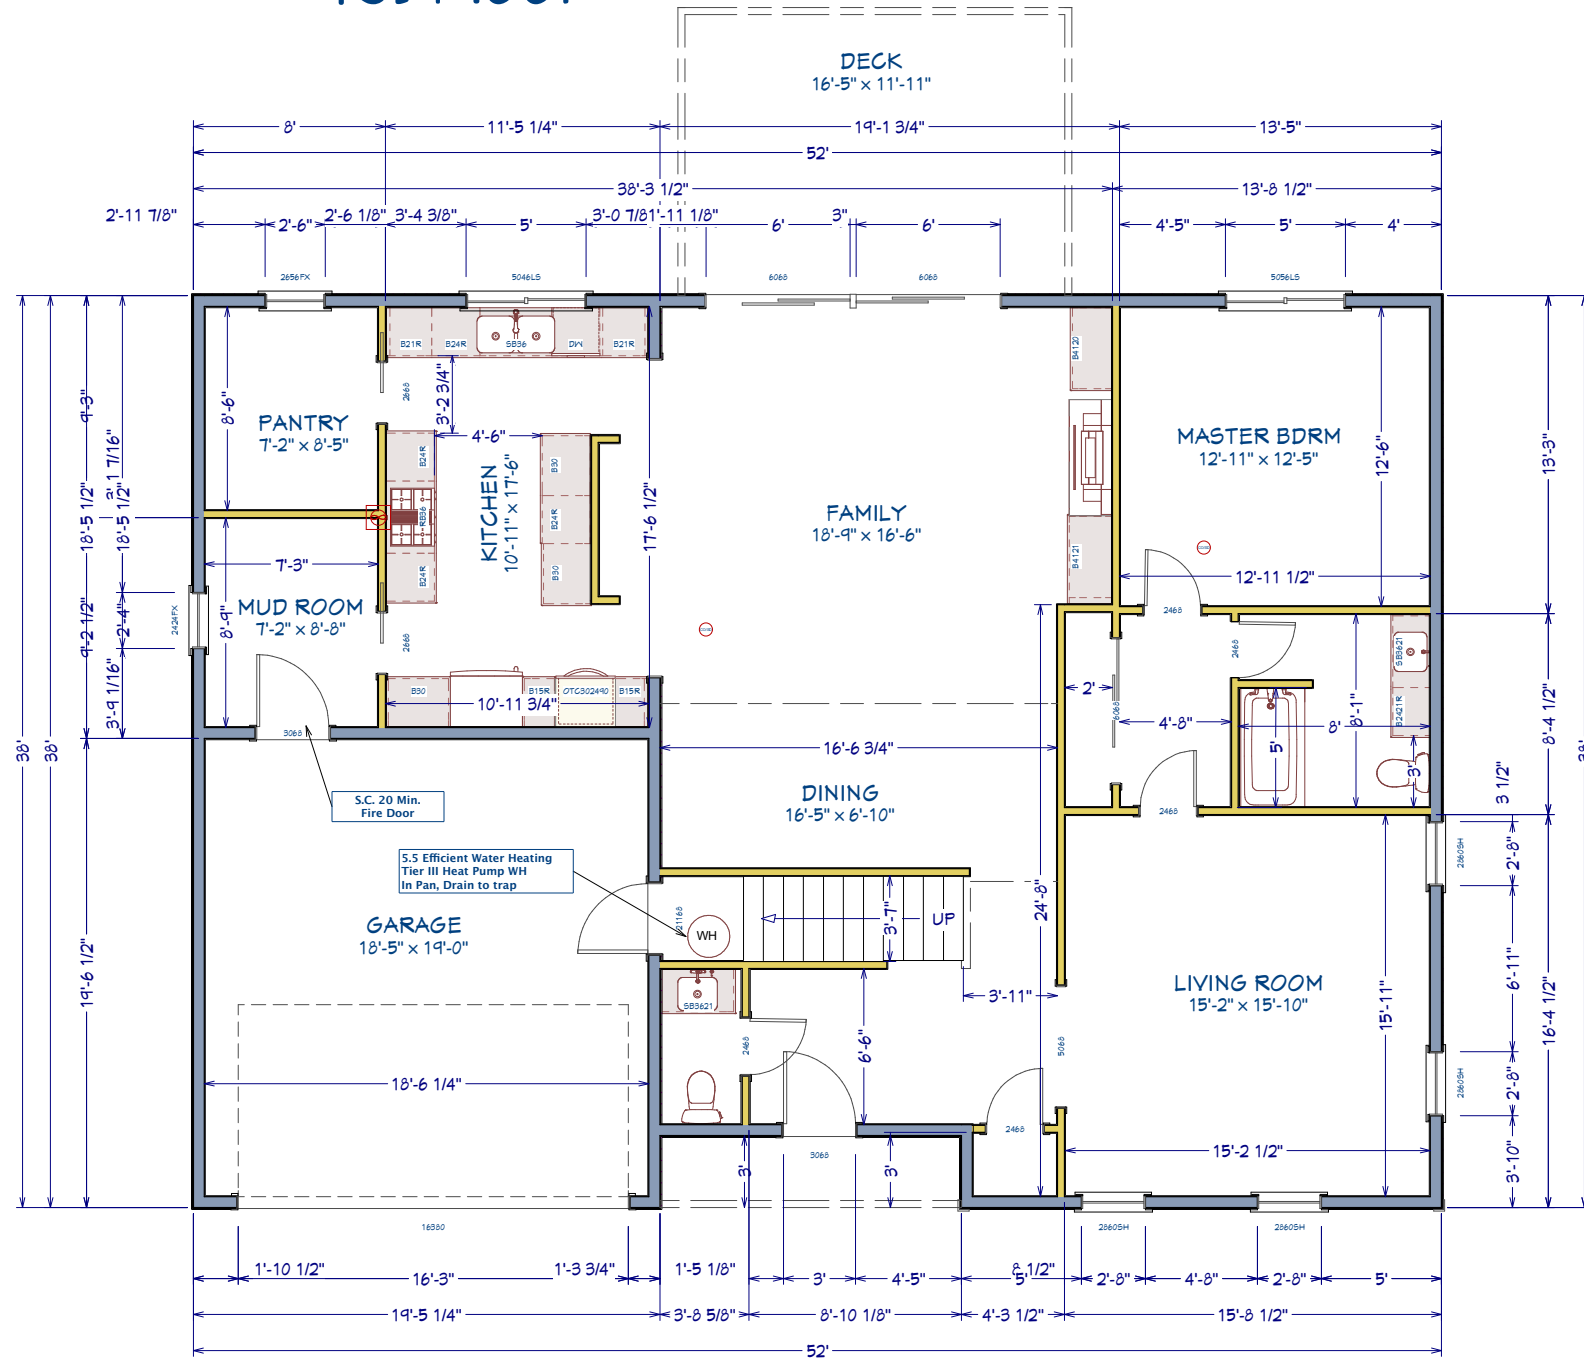

2nd Floor